


TAHUNA TERRACE

**AS-BUILT**

1921 TAHUNA TERRACE | NEWPORT BEACH | CALIFORNIA

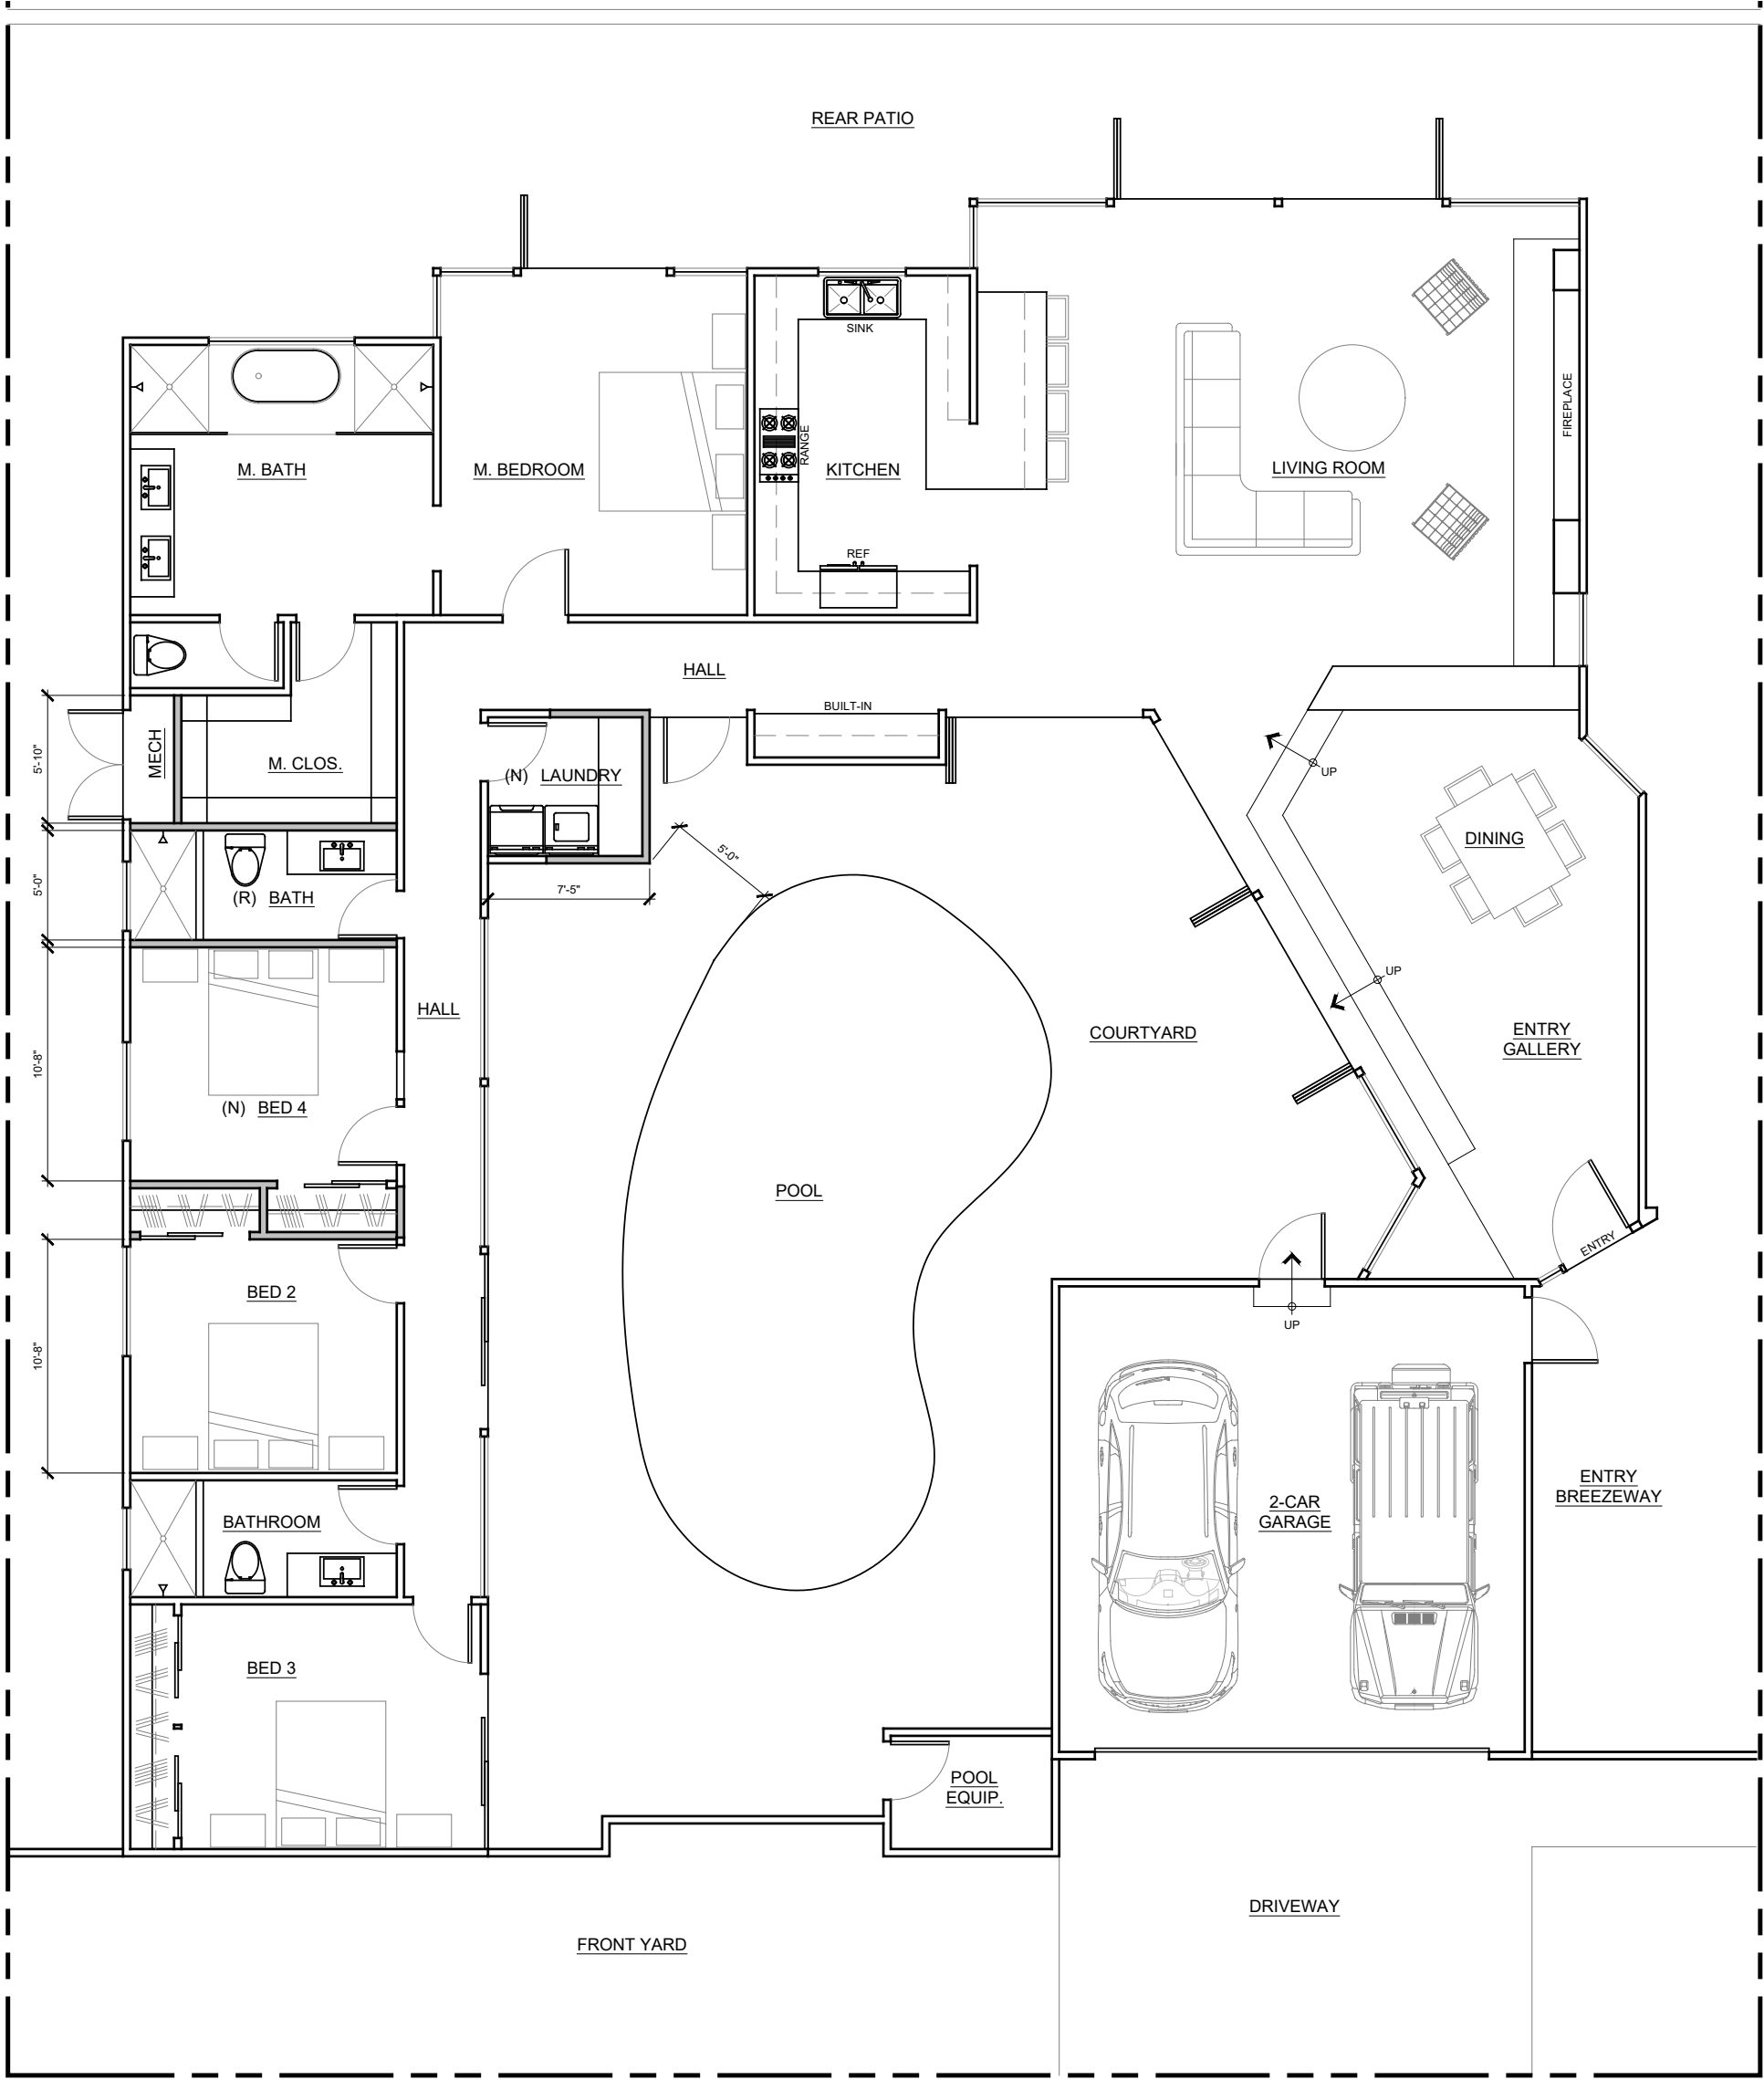

TAHUNA TERRACE

# PROPOSED FLOOR PLAN

1921 TAHUNA TERRACE | NEWPORT BEACH | CALIFORNIA